

**AAMA/WDMA/CSA 101/LS.2/A440-05  
TEST REPORT**

**Rendered to:**

**FLEETWOOD WINDOWS AND DOORS**

**SERIES/MODEL: Kona 3800 Vertical TDL**

**PRODUCT TYPE: Fixed Window**

<b>Title</b>	<b>Summary of Results</b>
Primary Product Designator	FW-C50 3048 x 3048 (120 x 120)
Design Pressure	±2400 Pa (±50.13 psf)
Air Infiltration @ 300 Pa (6.27 psf)	<0.05 L/s/m <sup>2</sup> (<0.01 cfm/ft <sup>2</sup> )
Air Infiltration @ 75 Pa (1.57 psf)	<0.05 L/s/m <sup>2</sup> (<0.01 cfm/ft <sup>2</sup> )
Water Penetration Resistance Test Pressure ASTM E 331	580 Pa (12.11 psf)
Water Penetration Resistance Test Pressure ASTM E 547	580 Pa (12.11 psf)
Uniform Load Structural Test Pressure	±3600 Pa (±75.19 psf)
Forced Entry Resistance	ASTM F 588 CAWM

**Test Completion Date:** 11/19/09

Reference must be made to Report No. 94550.02-301-44, dated 08/10/10 for complete test specimen description and data.

**AAMA/WDMA/CSA 101/I.S.2/A440-05 TEST REPORT**

Rendered to:

FLEETWOOD WINDOWS AND DOORS  
395 Smitty Way  
Corona, California 92879

Report No.: 94550.02-301-44  
Test Dates: 11/10/09  
Through: 11/19/09  
Report Date: 01/22/10  
Revision 3 Date: 08/10/10  
Record Retention End Date: 11/19/13

**Project Summary:** Architectural Testing, Inc. was contracted by Fleetwood Windows and Doors to perform and validate testing on a Series/Model Kona 3800 Vertical TDL fixed window. The sample tested successfully met the performance requirements for a FW-C50 3048 x 3048 (120 x 120) rating. Test specimen description and results are reported herein. The sample was provided by the client.

**Test Specification:** The test specimen was evaluated in accordance with the following

AAMA/WDMA/CSA 101/I.S.2/A440-05, *Standard/Specification for Windows, Doors, and Unit Skylights.*

CAWM 301, *Forced Entry Resistance Tests for Windows.*

**Test Specimen Description:**

**Series/Model:** Kona 3800 Vertical TDL

**Product Type:** Fixed

**Overall Size:** 3048 mm (120") wide by 3048 mm (120") high

**Daylight Opening Size:** 1454 mm (57-1/4") wide by 2972 mm (117") high

**Overall Area:** 9.29 m<sup>2</sup> (100.00 ft<sup>2</sup>)

**Finish:** Anodized Aluminum

**Test Specimen Description:** (Continued)

**Frame Construction:** All members were constructed of extruded aluminum. The vertical frame members' corners were routed to fit the horizontal framing members and fully sealed with silicone. The frame corners were attached using three (3) #10 1" long stainless steel Phillips head screws. The vertical frame member dividing each lite was attached with two (2) #10 1" long stainless steel Phillips head screws. All frame members were thermally broken.

**Weatherstripping:** No weatherstripping was utilized.

**Glazing Details:** The specimen utilized 1" thick annealed glass units fabricated from two 3/16" thick annealed sheets and a 5/8" thick airspace. The glass was set from the exterior against a vinyl bulb gasket and Tremco silicone at the interior. An aluminum glazing stop and a vinyl bulb gasket was applied from the exterior. The glass bite was 1/2".

**Drainage:**

<u>Description</u>	<u>Quantity</u>	<u>Location</u>
1/2" by 1/4" weep slots	4	6" from all corners in the sill face
2" by 1/2" weep slots	4	6" from all sill corners in the glazing stop leg
1" weep notch	4	6" from corners in center leg of sill

**Hardware:** No hardware was utilized.

**Reinforcement:** No reinforcement was utilized.

**Installation:** The test specimen was installed into a two layer nominal 2 x 8 Douglas Fir test buck. Thirty-two (32) #10 x 2" wood screws were located in all perimeter frame members located 6" from each corner and 16" on center. The rough opening was 1/4" wider and taller than the unit.

**Test Results:** The temperature during testing was 21°C (70°F). The results are tabulated as follows:

<u>Paragraph</u>	<u>Title of Test - Test Method</u>	<u>Results</u>	<u>Allowed</u>
5.3.2.1	Air Leakage Resistance per ASTM E 283		
	75 Pa (1.57 psf)	<0.05 L/s/m <sup>2</sup> (<0.01 cfm/ft <sup>2</sup> )	1.5 L/s/m <sup>2</sup> (0.3 cfm/ft <sup>2</sup> ) max.
	300 Pa (6.27 psf)	<0.05 L/s/m <sup>2</sup> (<0.01 cfm/ft <sup>2</sup> )	1.5 L/s/m <sup>2</sup> (0.3 cfm/ft <sup>2</sup> ) max.

**Note #1:** The tested specimen meets (or exceeds) the performance levels specified in AAMA/WDMA/CSA 101/I.S.2/A440-05 for air leakage resistance.

5.3.3.2 Water Penetration Resistance per ASTM E 547 and E 331 See Note #2

**Note #2:** The client opted to start at a pressure higher than the minimum required. Those results are listed under "Optional Performance".

5.3.4.2 Uniform Load Deflection per ASTM E 330 See Note #2

5.3.4.3 Uniform Load Structural per ASTM E 330 See Note #2

5.3.5 Forced Entry Resistance per ASTM F 588

Type: D Grade: 10

Disassembly Test	No entry	No entry
Lock Hardware Manipulation Test	No entry	No entry

Forced Entry Resistance per CAWM

Type: V

Disassembly Test	No entry	No entry
Test A	No entry	No entry
Test B	No entry	No entry

**Test Results:** (Continued)

<u>Paragraph</u>	<u>Title of Test - Test Method</u>	<u>Results</u>	<u>Allowed</u>
<u>Optional Performance</u>			
4.4.2.6	Water Penetration Resistance per ASTM E 547 and E 331 580 Pa (12.11 psf)	No leakage	No leakage
4.4.2.6	Uniform Load Deflection per ASTM E 330 (Deflections were taken on the vertical member) (Loads were held for 10 seconds)		
	2400 Pa (50.13 psf) (positive)	27.5 mm (1.08")	See Note #3
	2400 Pa (50.13 psf) (negative)	23.8 mm (0.94")	See Note #3

***Note #3:** The deflections reported are not limited by AAMA/WDMA/CSA 101/I.S.2/A440-05 for this product designation. The deflection data is recorded in this report for special code compliance and information only.*

4.4.2.6	Uniform Load Structural per ASTM E 330 (Permanent sets were taken on the vertical member) (Loads were held for 10 seconds)		
	3600 Pa (75.19 psf) (positive)	1.5 mm (0.06")	9.1 mm (0.36") max.
	3600 Pa (75.19 psf) (negative)	0.8 mm (0.03")	9.1 mm (0.36") max.

Tape and film not used to seal against air leakage during structural testing.

**Drawing Reference:** The test specimen drawings have been reviewed by Architectural Testing and are representative of the test specimen reported herein.

**List of Official Observers:**

<u>Name</u>	<u>Company</u>
Nathan Baker	Fleetwood Window and Doors
Tyler Westerling, P.E.	Architectural Testing, Inc.

Detailed drawings, data sheets, representative samples of test specimens, a copy of this report, or other pertinent project documentation will be retained by Architectural Testing, Inc. for a period of four years from the original test date. At the end of this retention period, such materials shall be discarded without notice and the service life of this report will expire.

Results obtained are tested values and were secured by using the designated test methods. If test specimen contains glazing, no conclusions of any kind regarding the adequacy or inadequacy of the glass in the test specimen can be made. This report does not constitute certification of this product nor an opinion or endorsement by this laboratory. It is the exclusive property of the client so named herein and relates only to the specimen(s) tested. This report may not be reproduced, except in full, without the written approval of Architectural Testing, Inc.

For ARCHITECTURAL TESTING, INC.

---

Tyler Westerling, P.E.  
Project Engineer

---

Leaton Kirk  
Director – Regional Operations

TW:ss

Attachments (pages): This report is complete only when all attachments listed are included.

- Appendix-A: Alteration Addendum (1)
- Appendix-B: Test Equipment (1)
- Appendix-C: Photographs (1)
- Appendix-D: Drawings (3)

### Revision Log

<u>Rev. #</u>	<u>Date</u>	<u>Page(s)</u>	<u>Revision(s)</u>
0	01/22/10	N/A	Original report issue
1	02/22/10	2	Updated glazing description to non-laminated
2	03/01/10	Cover, 1	Changed Curtainwall to Fixed Window
3	08/10/10	Cover	Changed reference report date

## Appendix A

### Alteration Addendum

**Alteration #1:** Date-10/01/09  
Cause for alteration- Failed Uniform Load per ASTM E 330  
Remedial action taken- Installation screws at head replaced with same size and type and less countersinking was employed.





**Appendix C**

**Photographs**



**Photo No. 1**  
**Water Penetration Test**


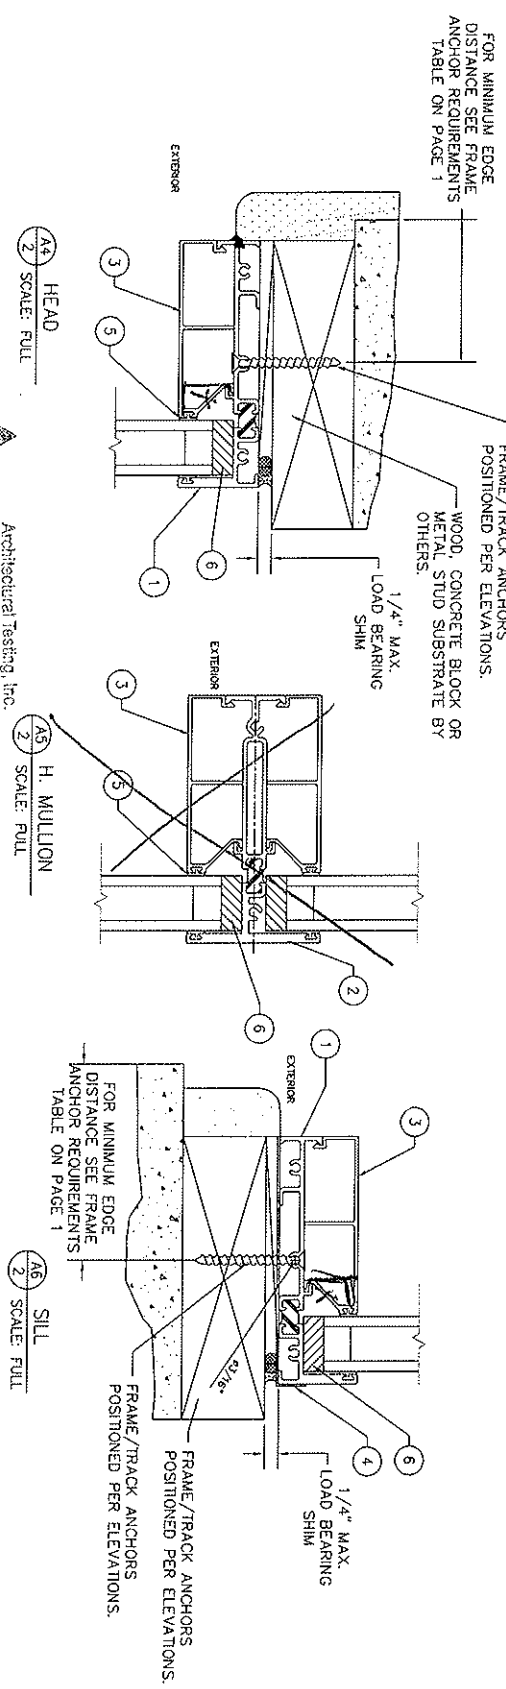


**Photo No. 2**  
**Structural Load Test**

## **Appendix D**

### **Drawings**



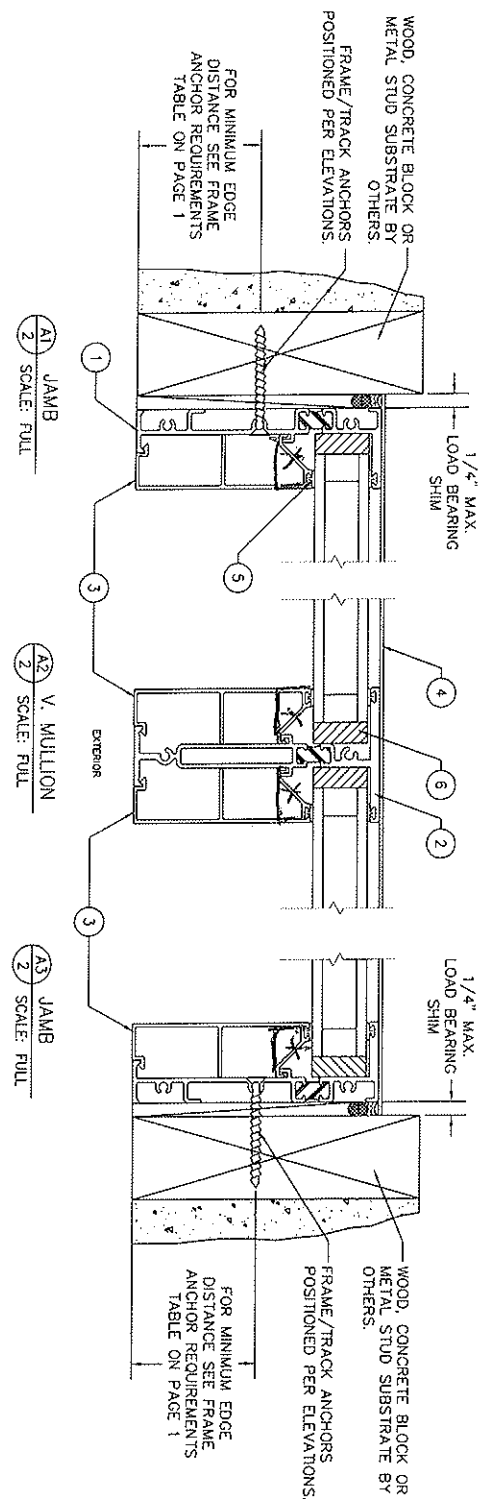


94550  
 JAN 05 2010


Architectural Testing, Inc.  
 Test sample complies with these details  
 Deviations are noted

YAL CAD OR INITIAL


<b>FLEETWOOD</b> WINDOWS AND DOORS 395 SMITTY AVE CORONA, CALIFORNIA 92630 - www.fleetwoodusa.com	TITLE: KONA 3500 - AAMA, FBC, ASTM 1886/1936 CERTIFICATION	DRAWN BY: KELVIN	DATE: 03/17/2009	REVISIONS:	DATE:	DRAWN BY:	COMMENTS:
	CUSTOMER: FLEETWOOD WINDOWS AND DOORS	JCTD NUMBER: 253695	JCTD NUMBER:	DATE:	DATE:	DATE:	COMMENTS:

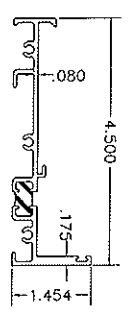


① SILL HEAD & JAMB

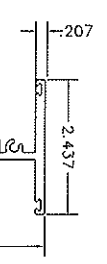


② MULLION

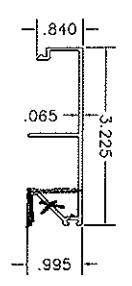


③ GLASS STOP

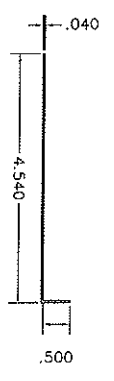

④ SILL PAN

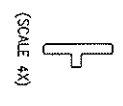

⑤ SANOPRENE BULB

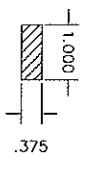

⑥ EDGE BLOCK


ITEM #	PART	ITEM DESCRIPTION
1	3805	SILL, HEAD JAMB EXTRUSIONS
2	3806	MULLION
3	3801	GLASS STOP
4	3822	SILL PAN
5	OVP04	SANOPRENE BULB
6	FW-1006	EDGE BLOCK

Architectural Testing, Inc.  
Test sample complies with these details  
Deviations are noted

94550

JAN 05 2010

Report:   
Tech:   
Date:

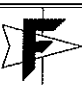 <b>FLEETWOOD</b> WINDOWS AND DOORS 355 SMITTY AVE CORONA, CALIFORNIA 92620 - www.fleetwoodusa.com	TITLE: KONA 3800 - AAMA, FIC, ASTM 1886/1996 CERTIFICATION CUSTOMER: FLEETWOOD WINDOWS AND DOORS JOB NAME: KONA 3800 CERTIFICATION	DRAWN BY: KLVN DATE: 02/17/2009	REVISIONS: <table border="1"><tr><th>NO.</th><th>DATE</th><th>DESCRIPTION</th></tr><tr><td> </td><td> </td><td> </td></tr></table>	NO.	DATE	DESCRIPTION				DRAWN BY: <table border="1"><tr><td> </td></tr></table>		COMMENTS: <table border="1"><tr><td> </td></tr></table>	
	NO.	DATE	DESCRIPTION										
SCALE: 1/1 DRAWING NO.: 1 CERT: 3800-09 SHEET: 1 3 of 3	JOB NUMBER: 253695	DRAWN BY: <table border="1"><tr><td> </td></tr></table>		DATE: <table border="1"><tr><td> </td></tr></table>		COMMENTS: <table border="1"><tr><td> </td></tr></table>							

VALUATION INITIAL: